APPROVED AS NOTED

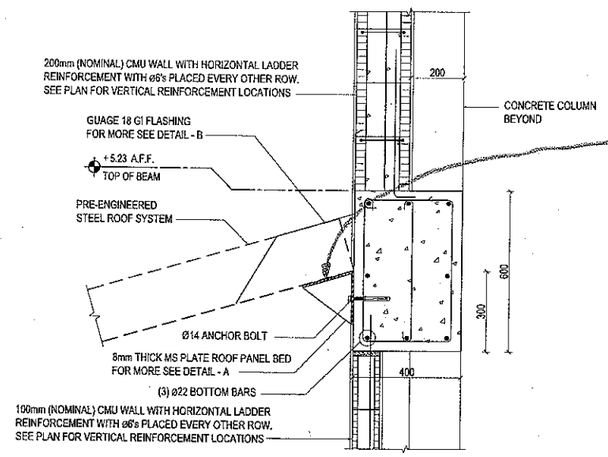

SHOW CONNECTION OF ROOF PANEL TO BENT PLATE.

1 (28-SD04) ROOF BEAM (13) TO(18) SECTION (Typ.)
SCALE: 1:10

VERIFY BENT PL. IS CONTINUOUS.

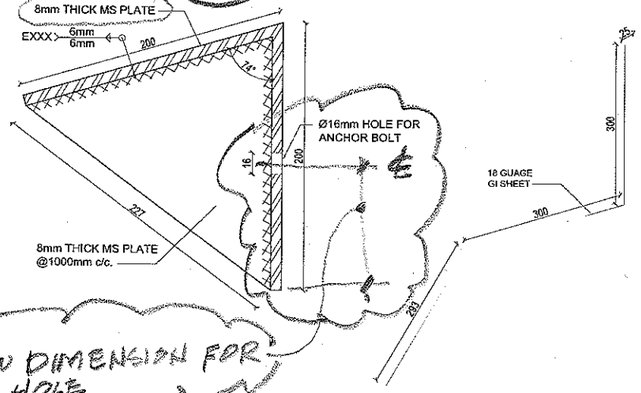

SHOW DIMENSION FOR BOLT HOLE

A (28-SD04) DETAIL
SCALE: 1:2

B (28-SD04) DETAIL
SCALE: 1:5

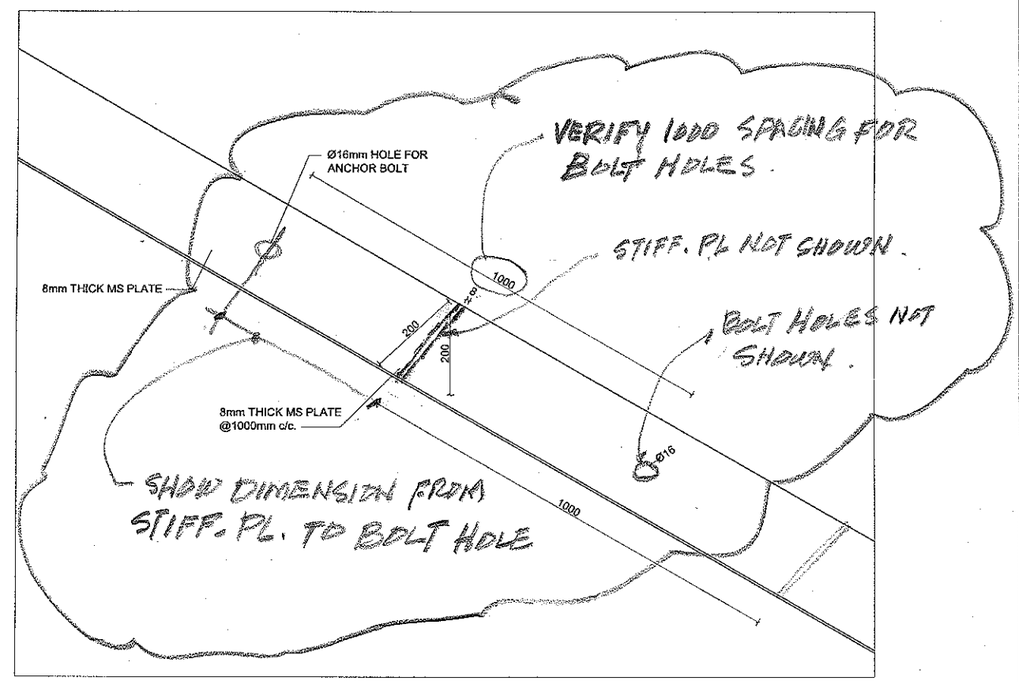

VERIFY 1000 SPACING FOR BOLT HOLES.

STIFF. PL NOT SHOWN.

BOLT HOLES NOT SHOWN.

SHOW DIMENSION FROM STIFF. PL. TO BOLT HOLE

2 (28-SD04) ROOF PANEL BED ISOMETRIC VIEW
SCALE: 1:5

USAID

Mark	Description	Date	Appr.	Mark	Description	Date	Appr.

Date: 29/11/2010 Rev.: D
Design file no.:
Drawing code:
File name: 16.6597.28.SD04.d
Plot date: Plot scale: As Shown

Designed by: Dwn by: Said Arif Chkd by:
Reviewed by:
Submitted by:

VCCI
Vanco-Amitar Construction Company
Street 14, Lane 3, House 69
Waqar Akbar Khan, Kohat, Afghanistan
0799-249 273 / 0797 208 757
070 200 4960
info@vanccorp.com
www.vanccorp.com

USAID-306-C-00-10-00501-00
ISLAMIC REPUBLIC OF AFGHANISTAN
MINISTRY OF HIGHER EDUCATIONS
RENOVATION OF BOTANY DEPARTMENT, KABUL UNIVERSITY
KABUL, AFGHANISTAN
BUILDING # 28
ROOF BEAM (13) TO (18) AND METAL PANEL CONNECTION DETAIL

SHEET REFERENCE NUMBER:
28-SD04
Sheet 04 of --